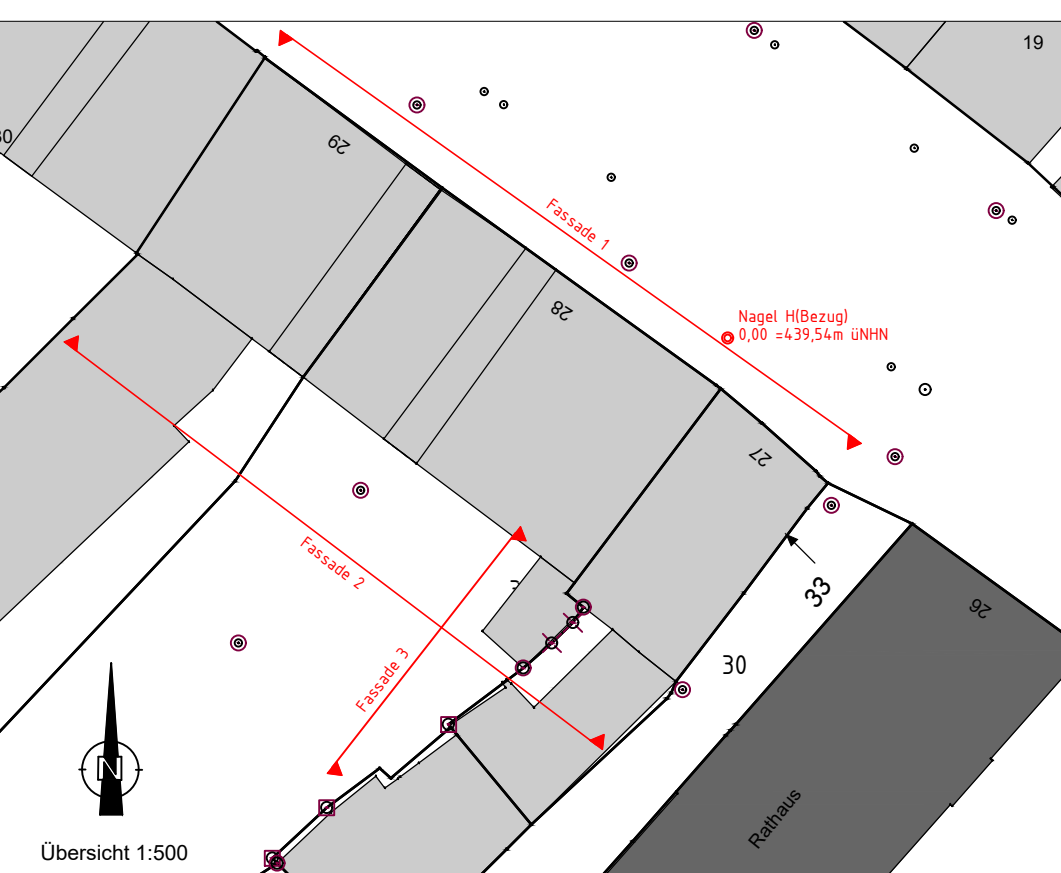


Fassade 1

Architectural elevation drawing of a building facade, labeled "Fassade 1". The drawing shows a multi-story building with a red roof, grey walls, and numerous windows. The facade is divided into three main sections. The left section has a grey wall with two rows of windows. The middle section has a grey wall with three rows of windows. The right section has a red roof with a central gabled section and a smaller section to the right. The drawing includes a vertical scale on the right side, ranging from -1m to 25m. The drawing is labeled "Fassade 1" in the top left corner. The drawing is a technical architectural drawing with precise lines and dimensions.

[illegible]