

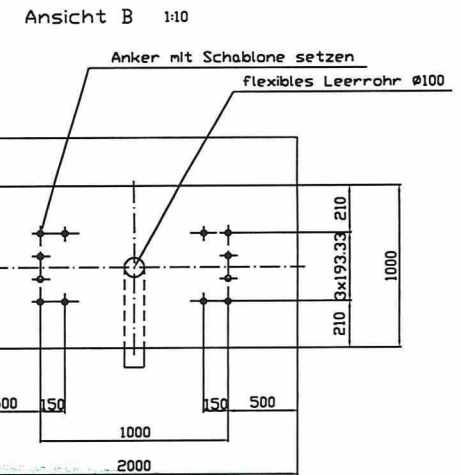
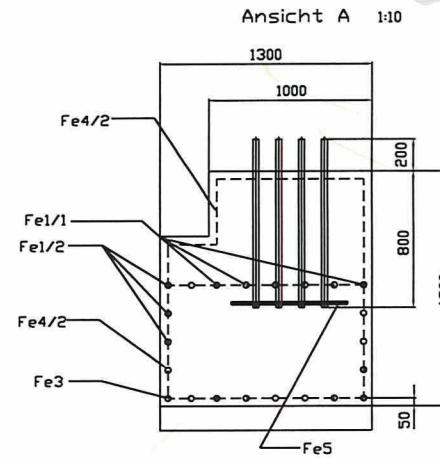


Grüneinträge beachten


12 Anker
M36/1000 V4a

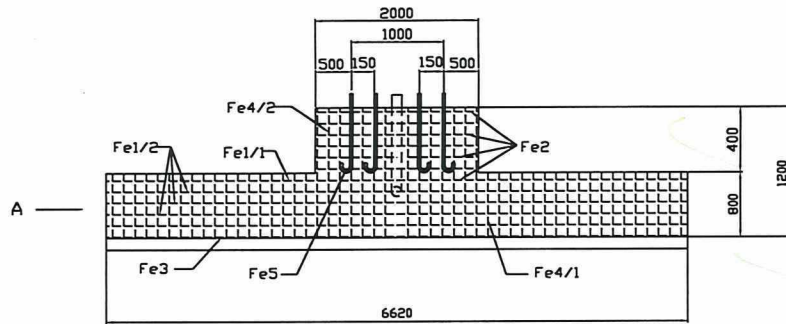

Ankersetzschaablone

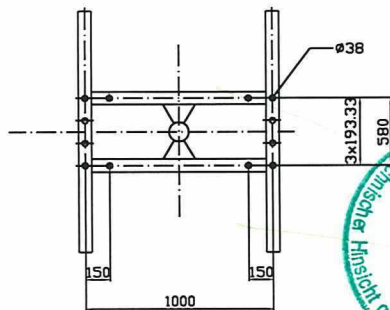

Ankerüberstand

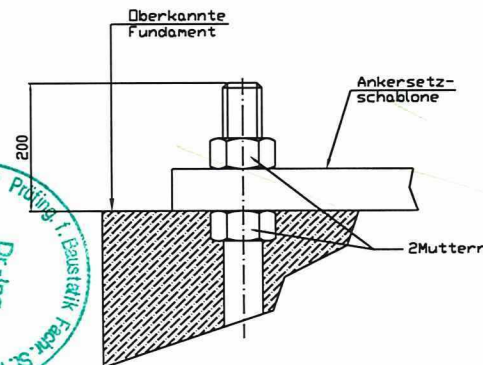

Stahlliste für 1 Fundament

Bez.	Stück	Ø	Länge	kg/m	kg
Anker	12	M36	1,0	7,990	95,88
Fe1/1	8	10	6,82	1,210	6,60
Fe1/2	8	10	6,82	0,617	3,60
Fe2	3	10	3,20	0,617	1,45
Fe3	8	12	6,82	1,580	7,54
Fe4/1	29	10	4,30	0,617	21,51
Fe4/2	10	10	4,30	0,617	2,63
Fe5	4	20	1,9	2,470	4,69

ABA Thüringen

Standort: BAB A4.AS Magdala
FR Dresden km 185+673

Stempel des Baustatikers (geprüft)

Stempel des Baustatikers (geprüft)

Stempel der Prüfung

Stempel der Prüfung

Pos.	Stk.	Benennung	Z-Nr./DIN-Nr.	Rohmaß	Verkefstoff	Benennung/Ident.Nr.
Schutzvermerk nach DIN 34 beachten						
Freimaßtoleranzen nach DIN 8570-AF						
Werk-Laden GmbH Wagendamm Schillerstraße Marie-Curie-Str.11 06219 Magdala Tel.: 0361/80009-0 Fax.: 0361/80009-89						
Benennung: Verkehrszzeichenausleger KR-Al-4.0/5.30m						Zeichnungs-Nr. 9900042-F
Nr. Änderung/Dat./Name						Seite von