
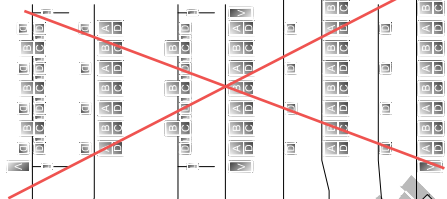
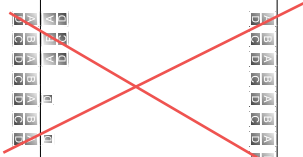


Ab hier
Baufeld Altona

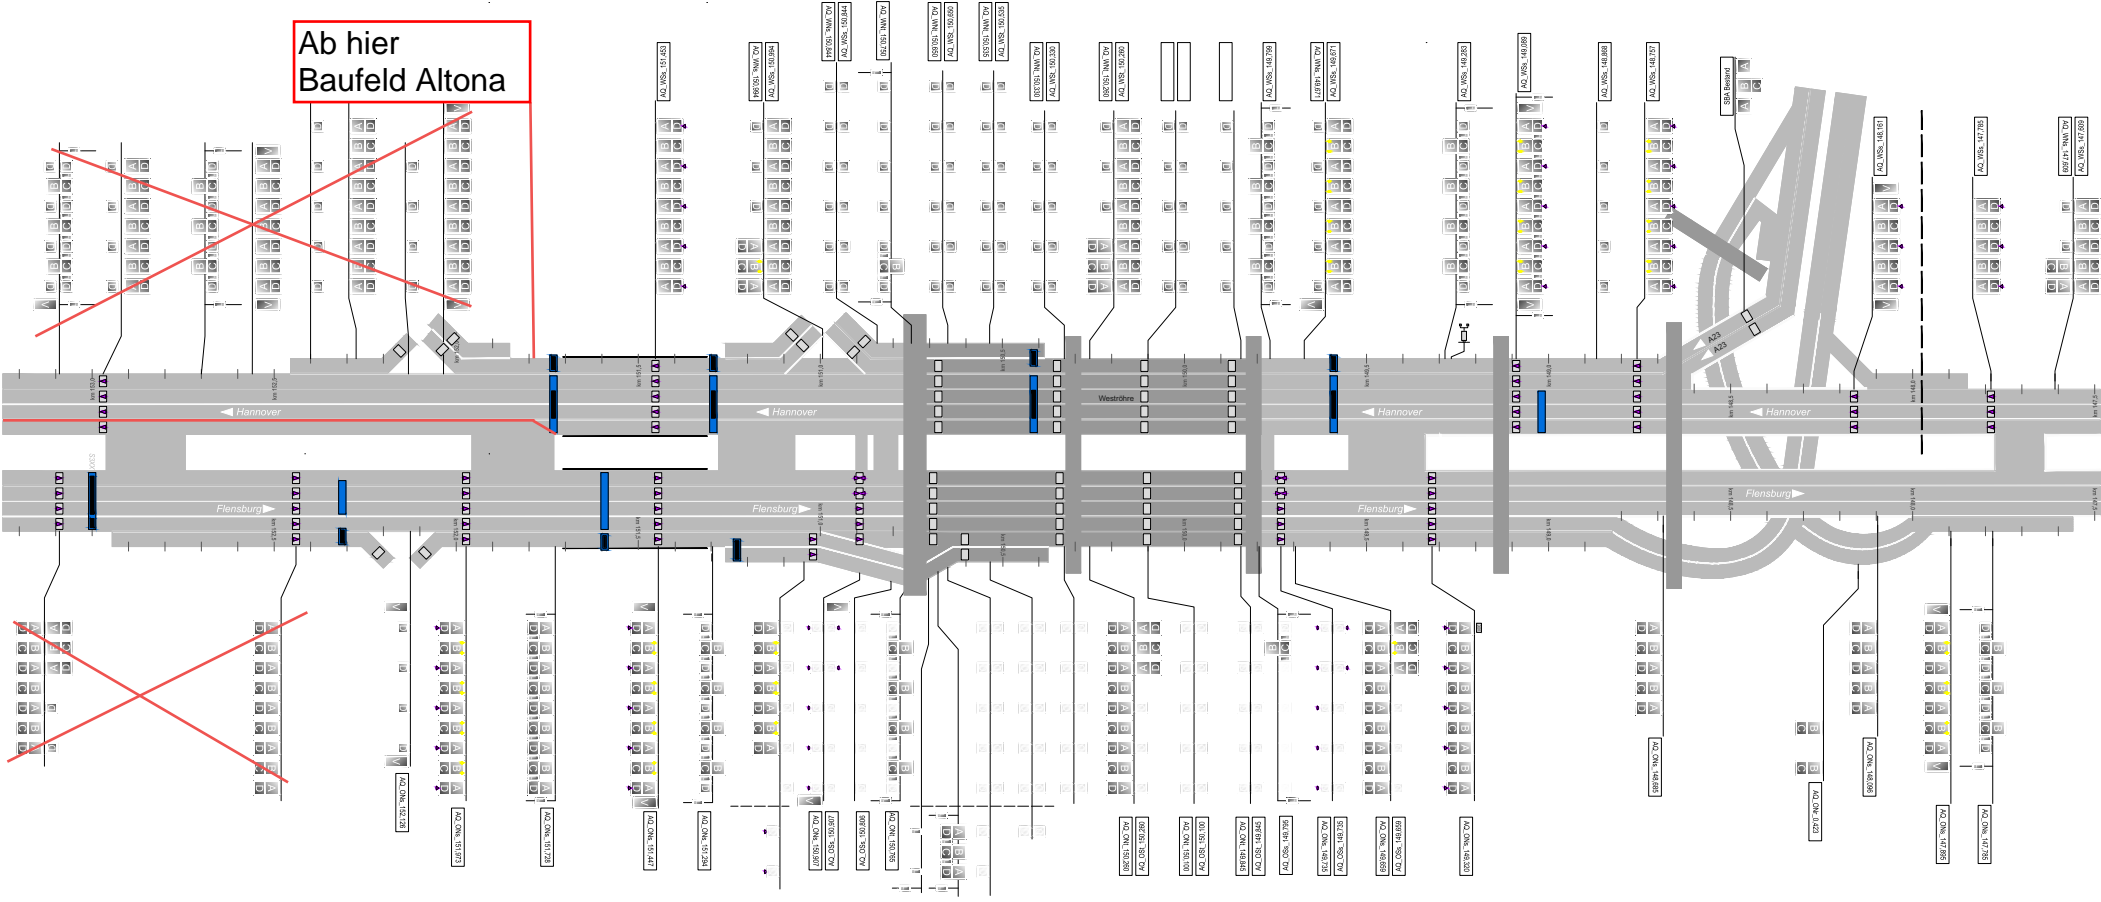

AS Hamburg
-Volkspark

AS Hamburg-
Stellingen

AD Hamburg
-Nordwest