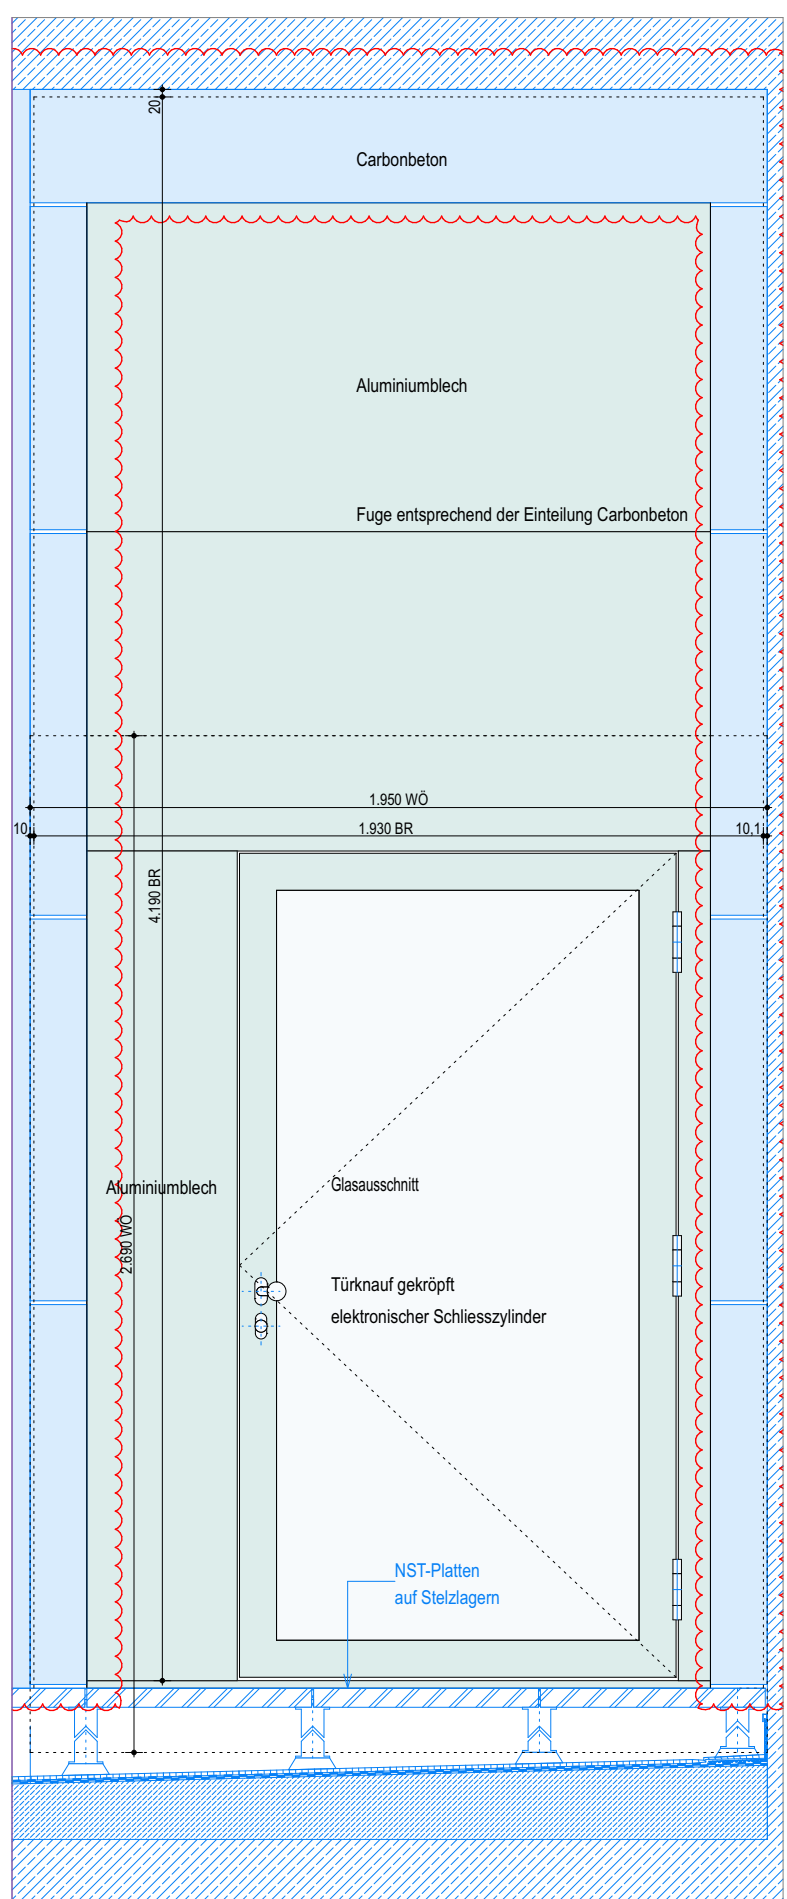
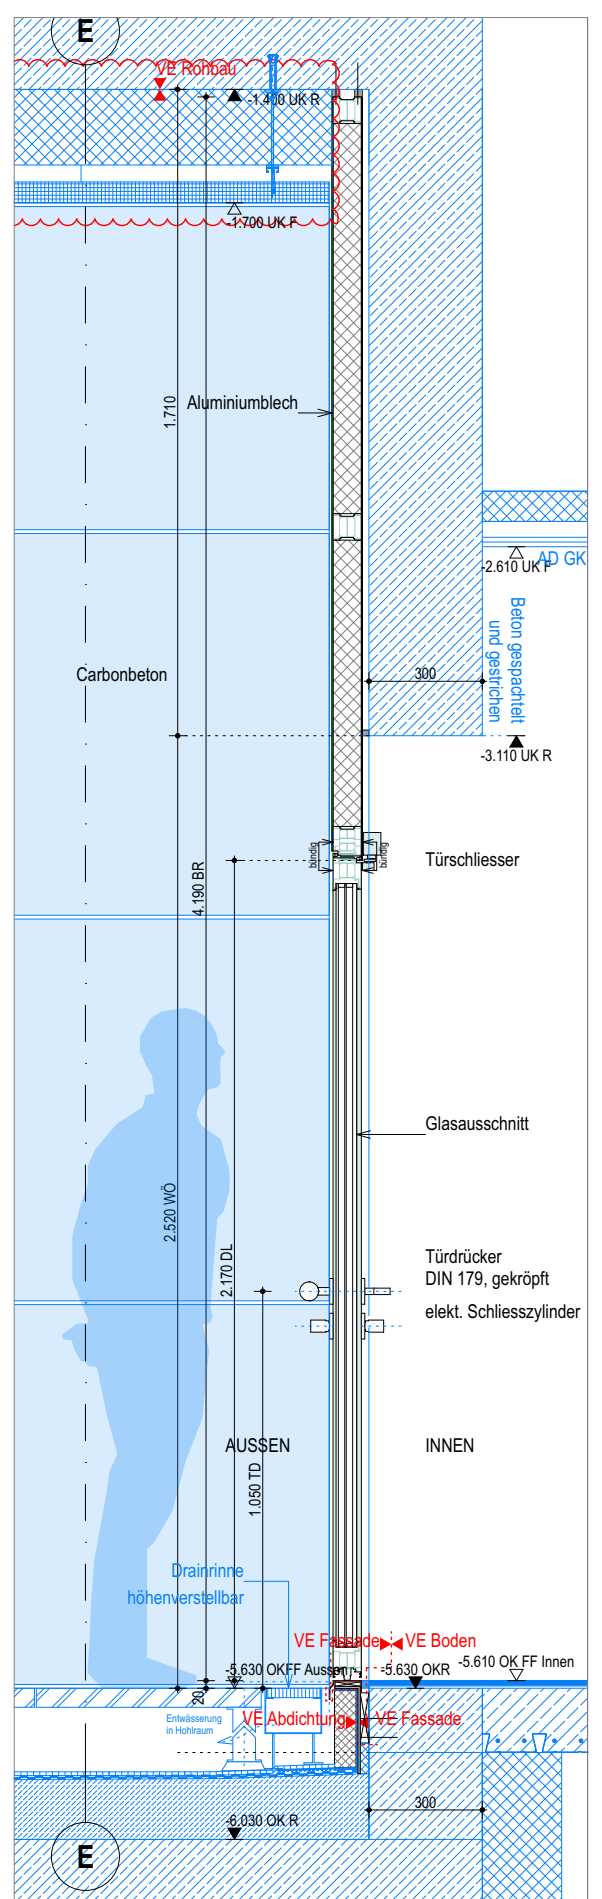
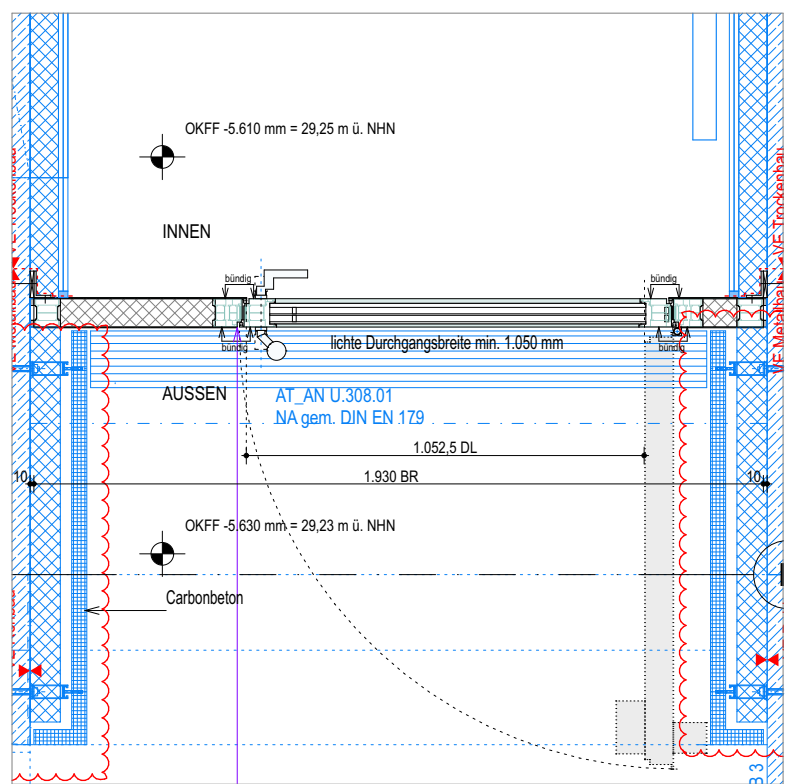



$$HB = 840.0 / 1730.0 (1.45 \text{ m}^3)$$