


Item Number	Quantity	Title	Document Number	Material	Comments
1	1	LAS SAM. OLIE TANK	54310000.1		819.8693
2	1	Vuldop met beluchter		Acier	819.8692
3	1	Zelfsluitende peilglas afsl. 1/2"		Messing	2648.207A
4	1	Peilglasknie 1/2"		Messing	2648.200A
5	1	Peilglas 13MM			2650.13
6	1	Vloterschakelaar			819.8691
7	1	KALKMAN NAAMPLAAT			819.8695
8	1	Plug G3/4"		Steel	2600.290.06

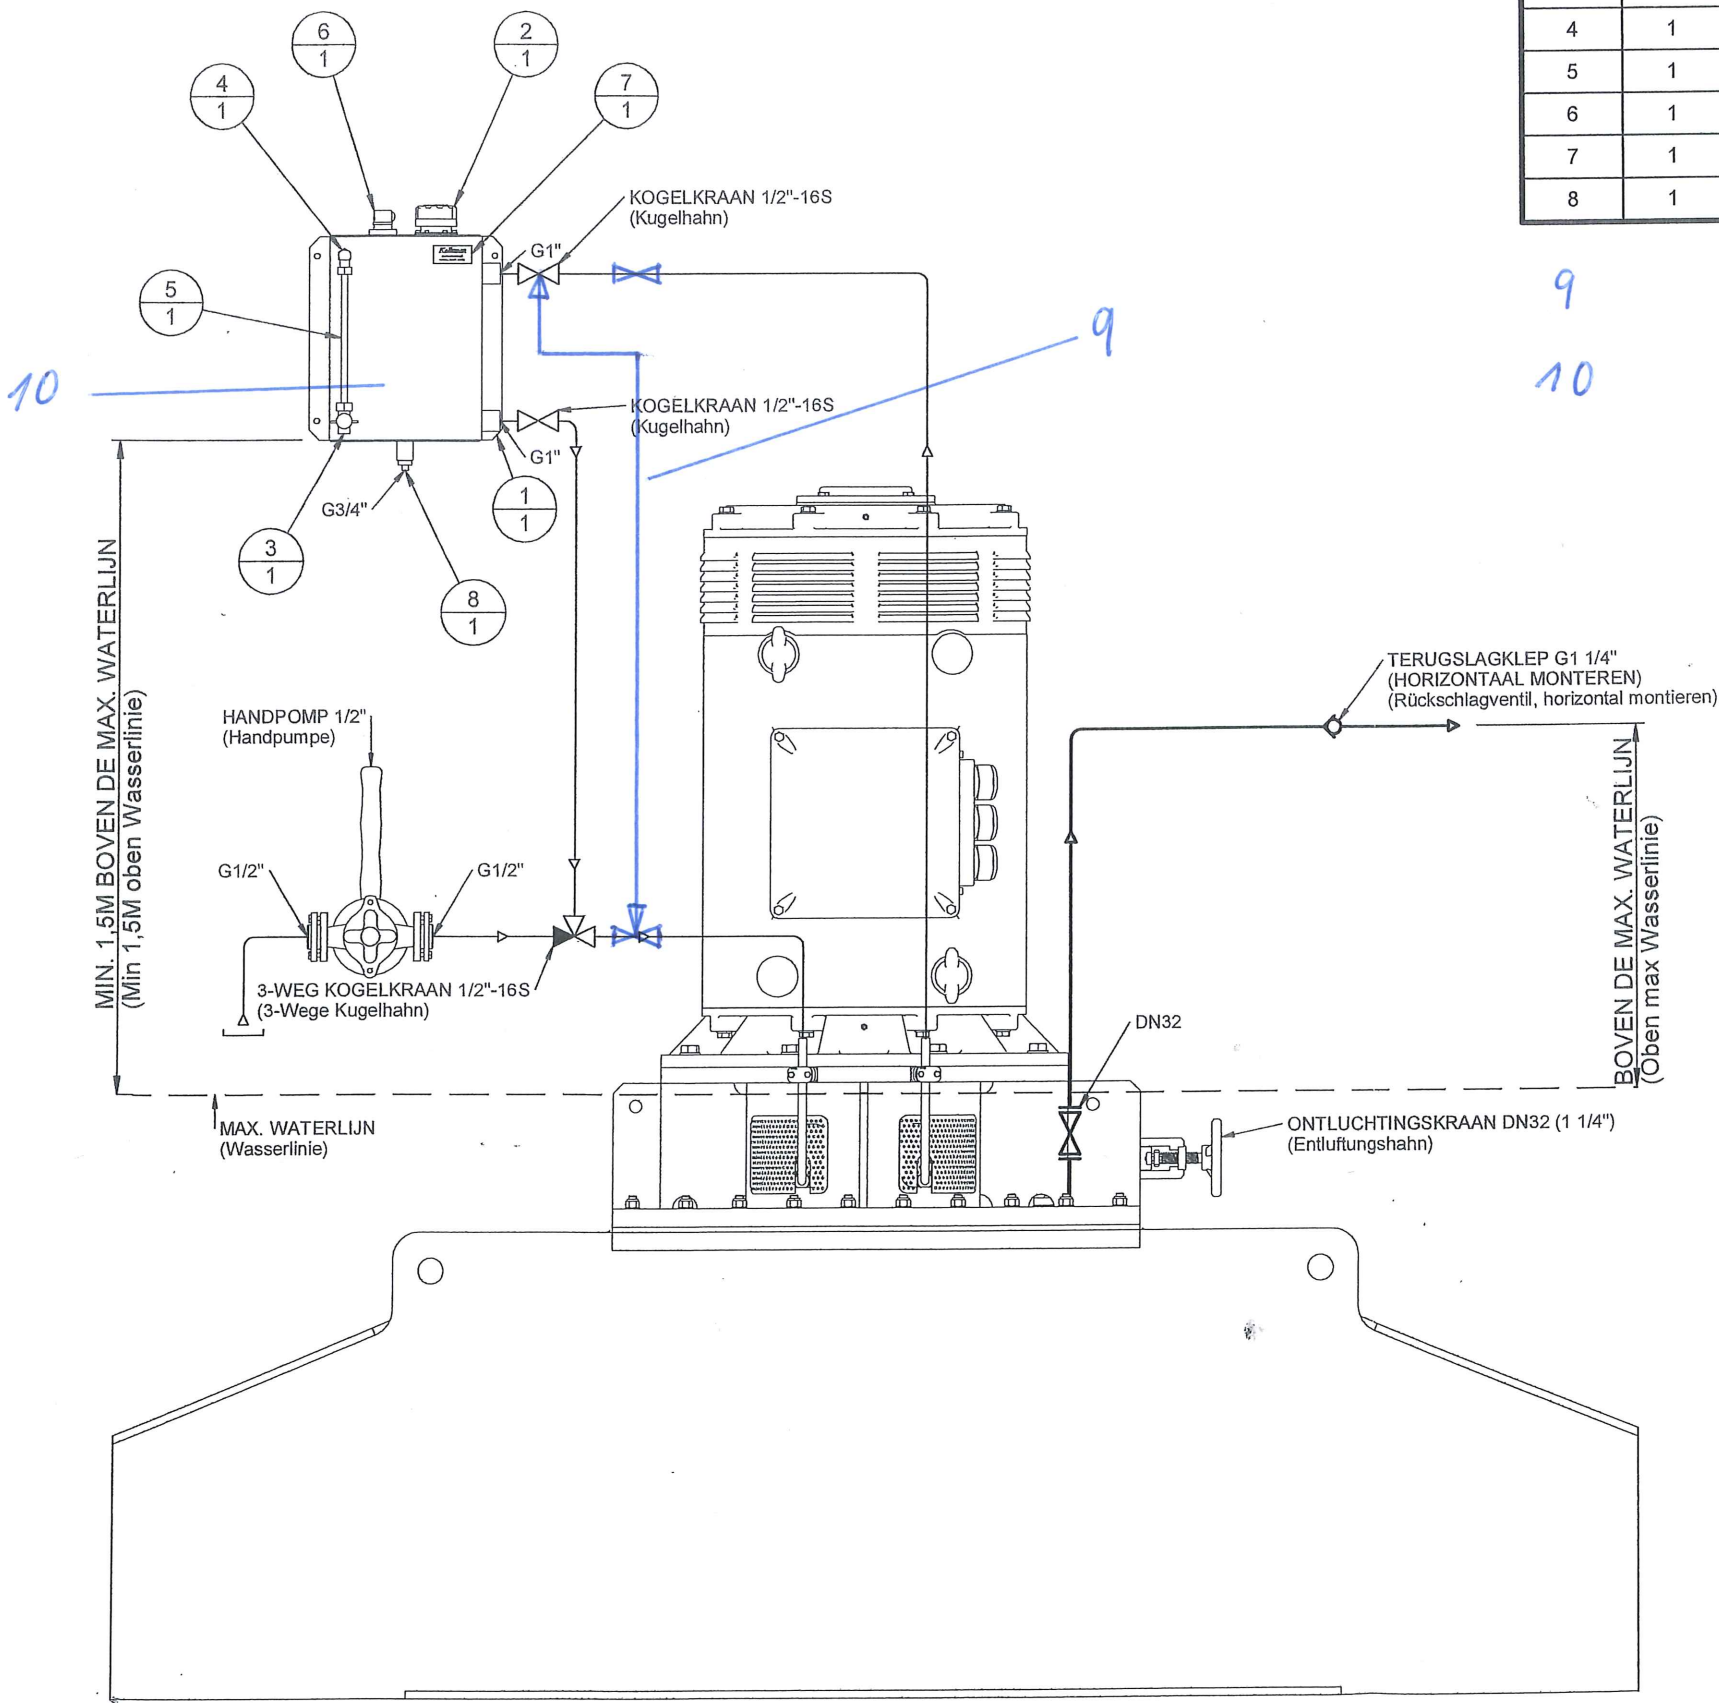

9 Verbindingsleiding
10 Ausgleichstank

Materiaal:		Kleur:	
MATEN ZONDER TOLERANTIE ± 0,5	GENERAL ROUGHNESS	SURFACE ROUGHNESS ACC. TO ISO 1302 GEOMETRICAL TOLERANCES ACC. TO EN ISO 1101	
HOEK TOLERANTIES	✓		
SCHAAL: 1:1	DATUM:	SAM. BOEGSCHROEF	
GETEKEND: JJB	FORMAAT:	BETA-272E SPITS	
ORDER NR:		BOEGSCHROEFEN	
kalkman SCHEEPSTECHNIEK BV		BESTEL NR.:	TEKENING NR.: Beta-272E-SPTS-001-01 rev B
Posibus 23 2920 AA Krieken a/d IJssel The Netherlands Telefoon +31 180 514664 Telefax +31 180 514650		THIS DRAWING REMAINS OUR PROPERTY, IT MAY NOT BE DUPLICATED BY ANY MEANS WITHOUT APPROVAL OF KALKMAN SCHEEPSTECHNIEK B.V.	