


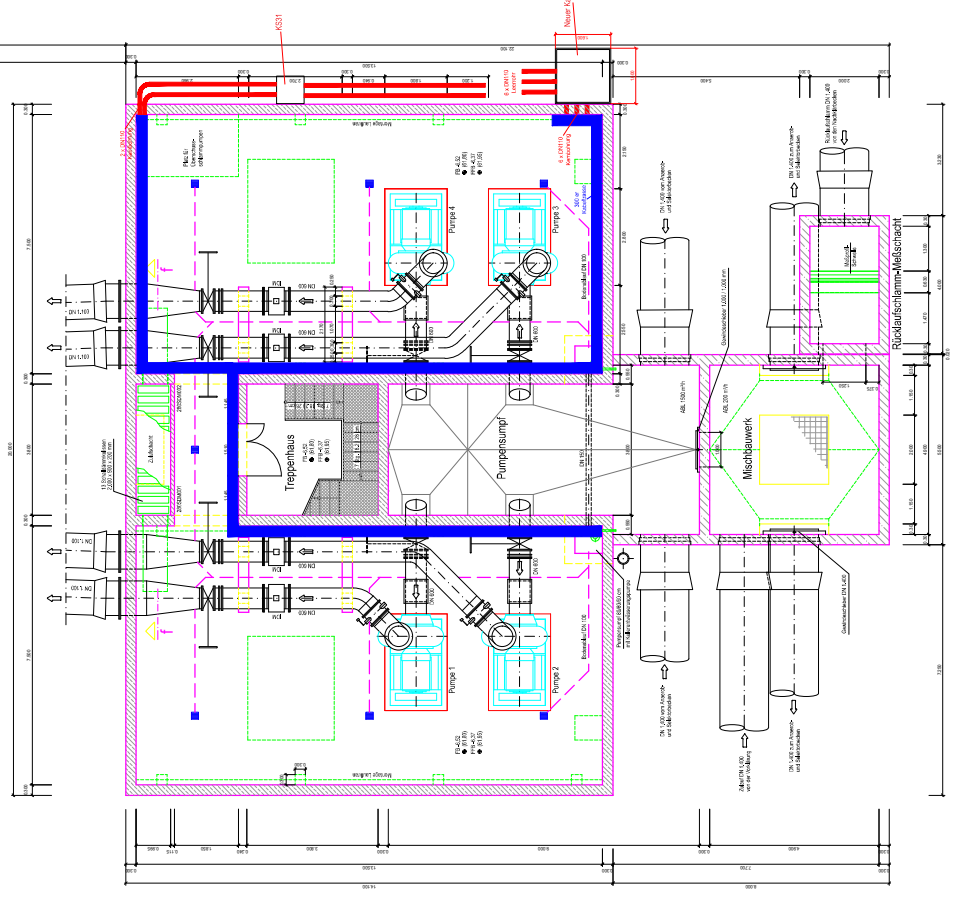

Kellergrundriss


[illegible]