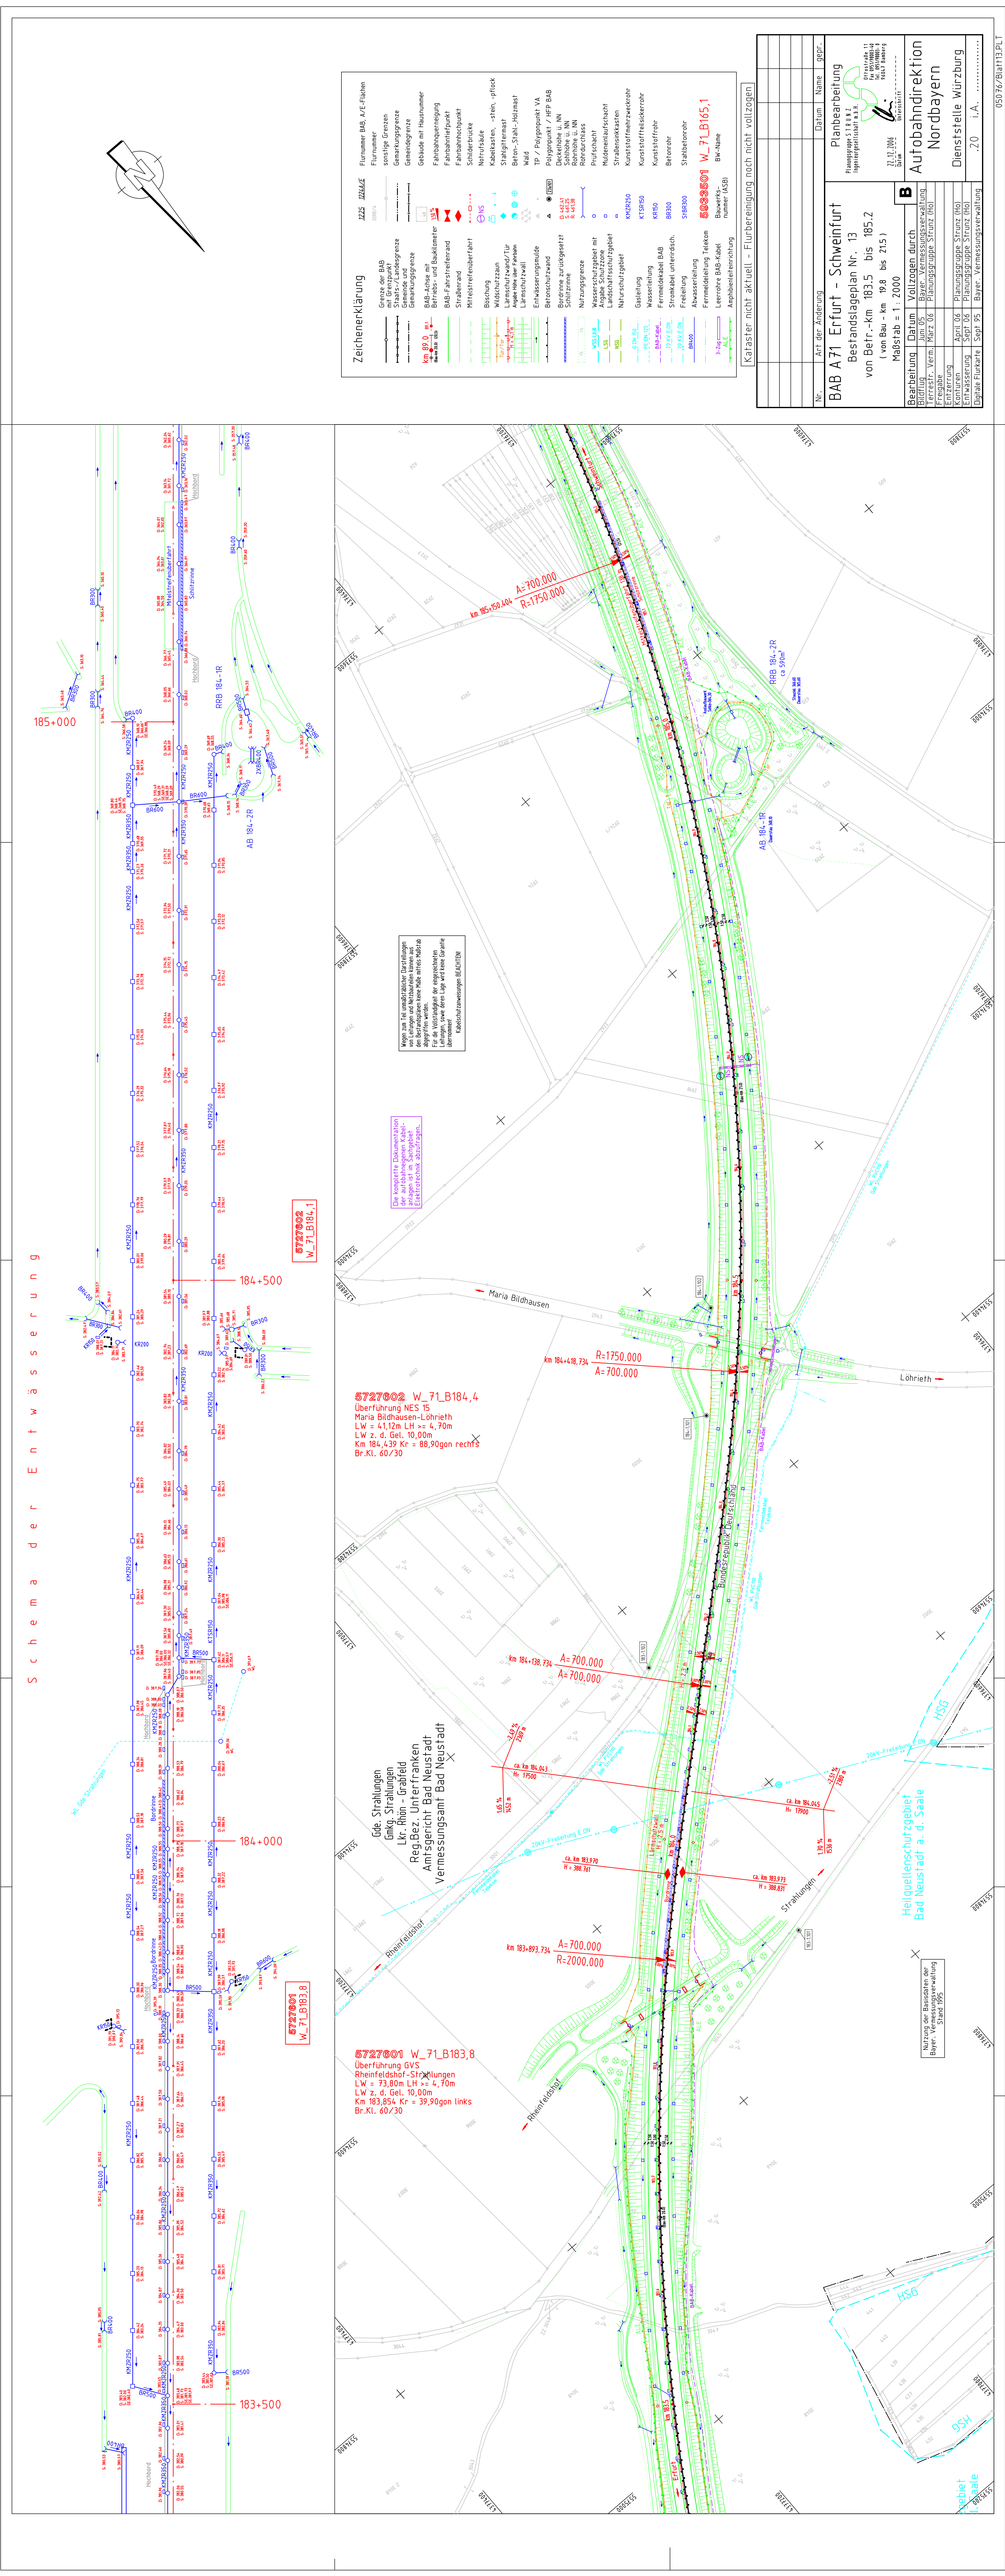
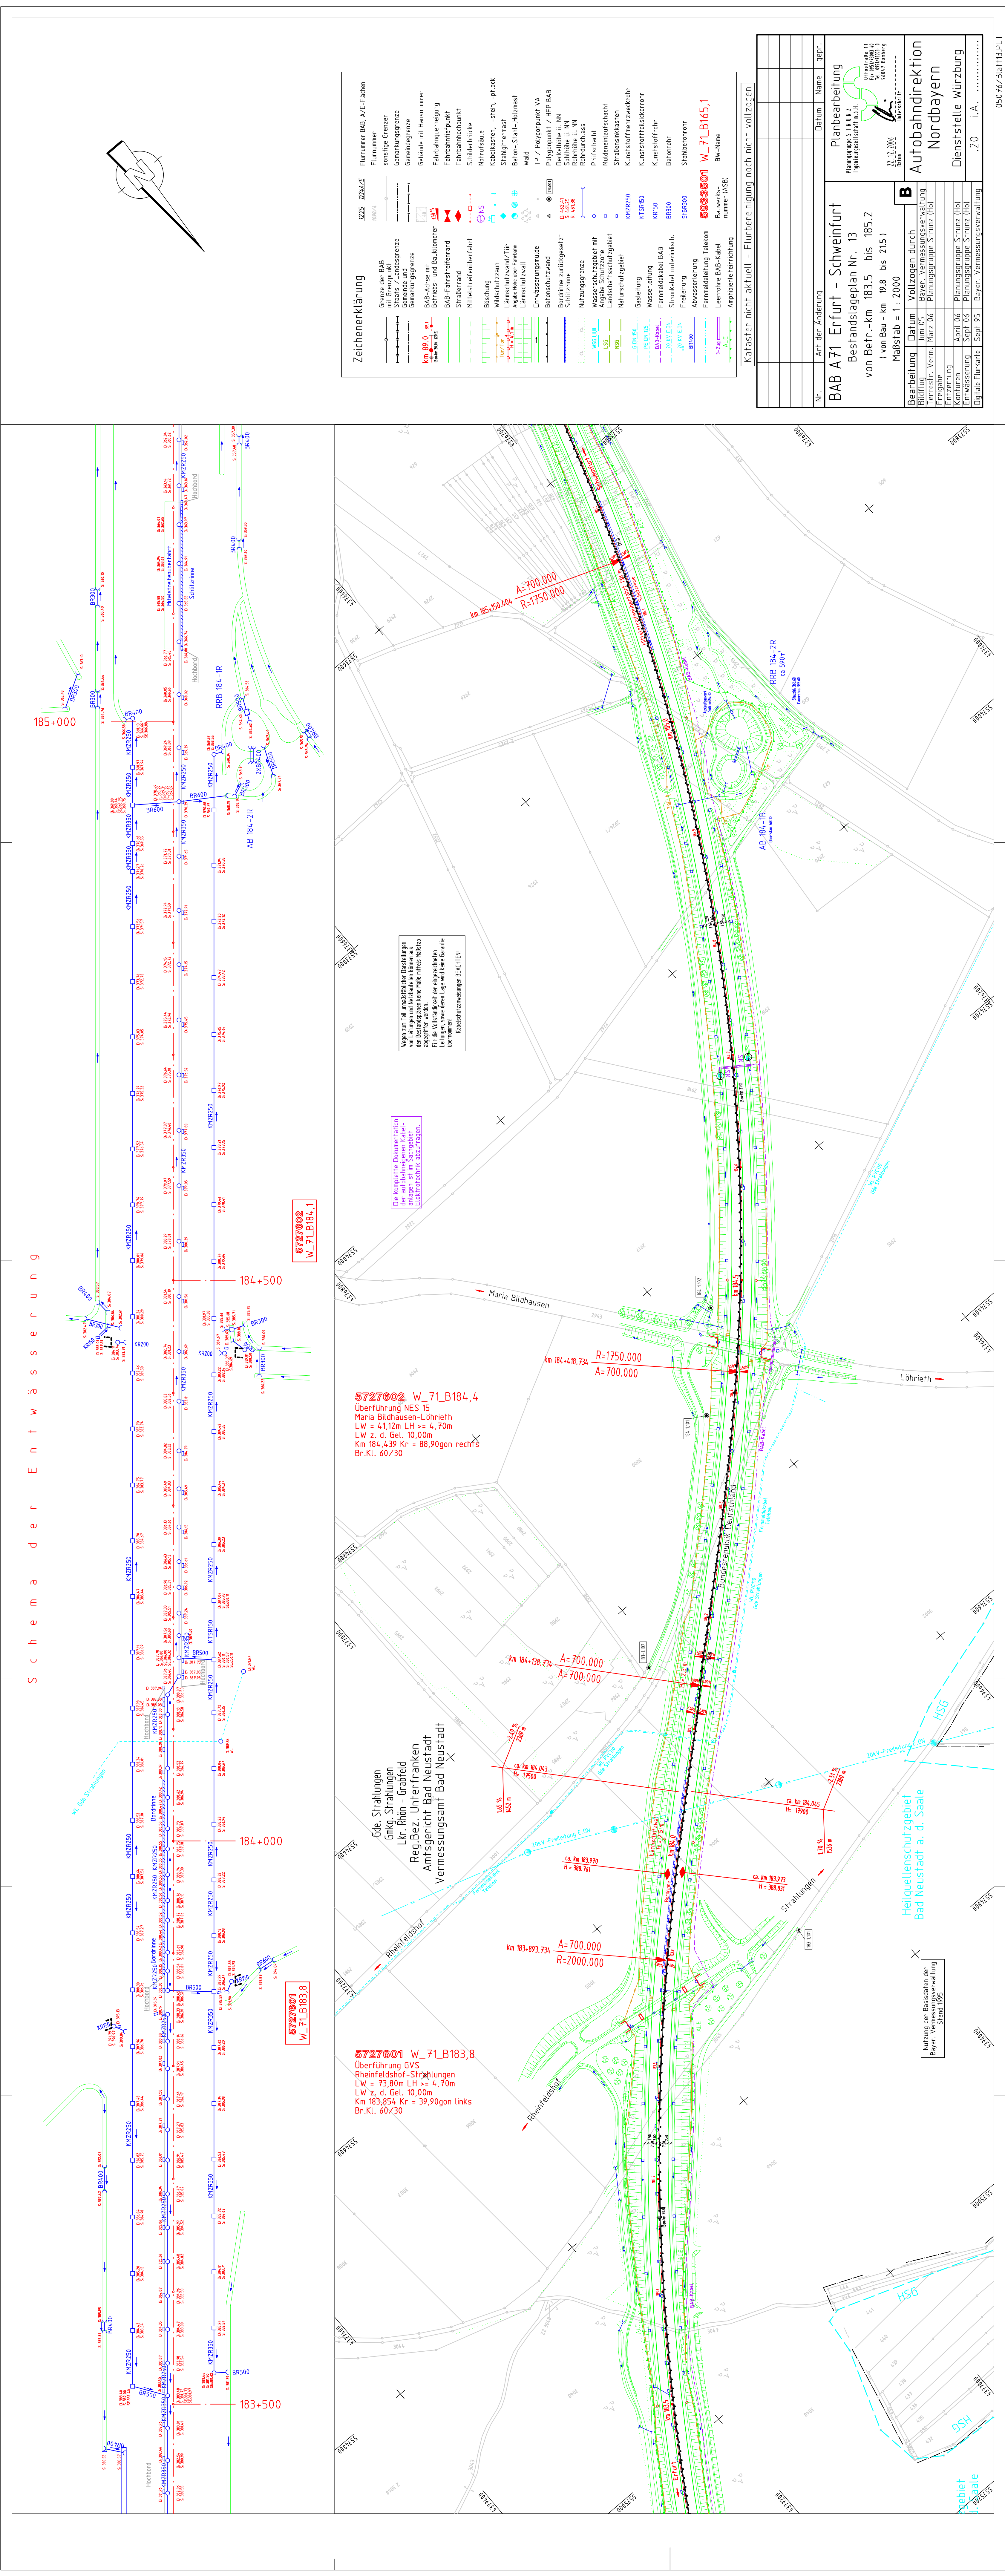


[illegible][illegible][illegible]