


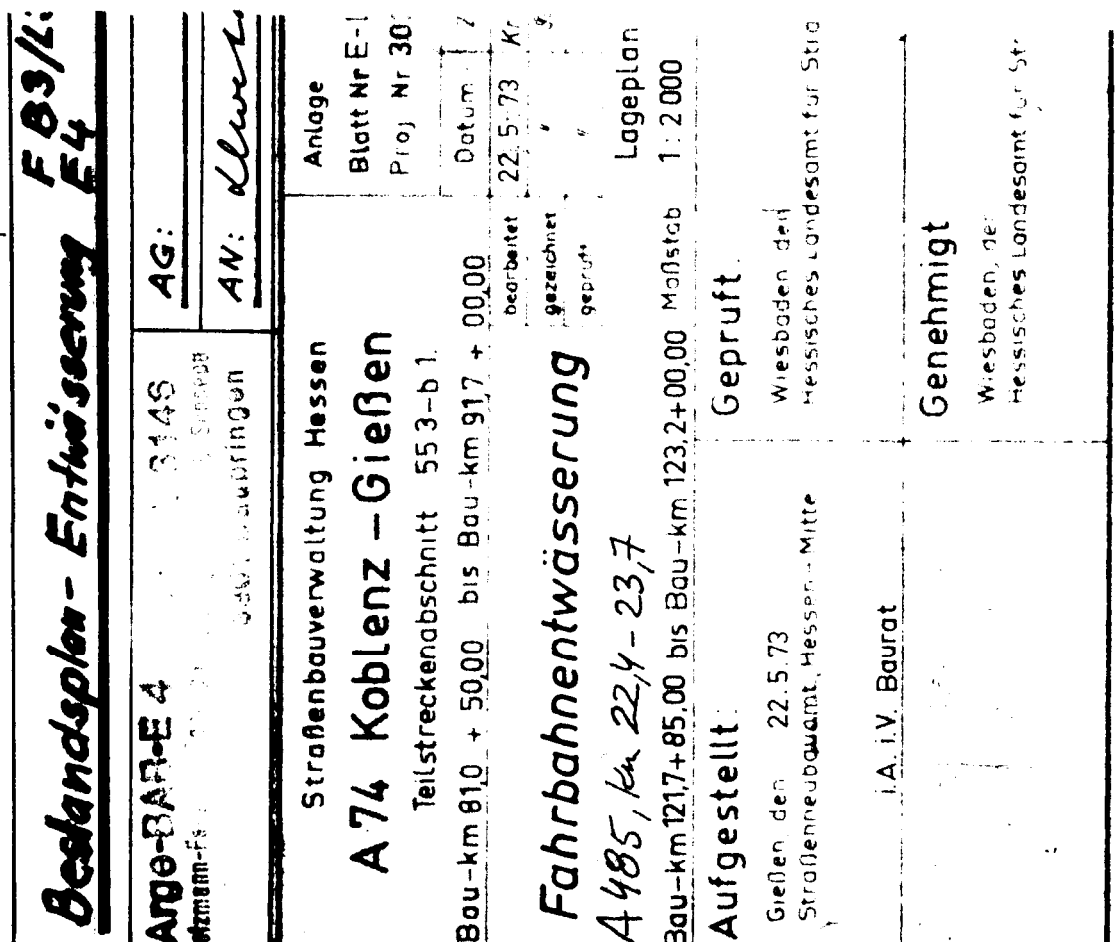

Fl. 25

K 87-9 (384)
Überführung W-Weg
Km 122,1+00,00
LW = 43,75 m; B = 6,00 m
LH = 4,724 m
Kr. $\rightarrow$ 100°