


Lfd. Nr.	Aufschlüsse	Koordinaten nach UTM		Ansatzhöhe Z m ü. NHN
		Rechtswert X	Hochwert Y	
1	B1	679979,14	5522415,16	530,54
2	B2	679975,36	5522399,52	530,39
3	B3	679980,69	5522381,48	530,14
4	B4	679972,00	5522372,55	530,20
5	B5	679955,85	5522353,58	528,67
6	B6	679966,96	5522335,55	527,86
7	S1	679975,77	5522410,04	530,51
8	S2	679981,71	5522397,77	530,39
9	S3	679973,11	5522382,23	530,19
10	S4	679979,84	5522371,76	530,13
11	S5	679986,10	5522400,78	530,17
12	S6	679989,09	5522397,72	529,06

Zeichenerklärung:

- Bohrungen
- ✗ Sondierungen

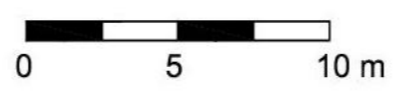

Trockau Autobahnmeisterei Anbau einer Technikzentrale	
Maßstab 1: 250	Lageplan
	Anlage 2/1