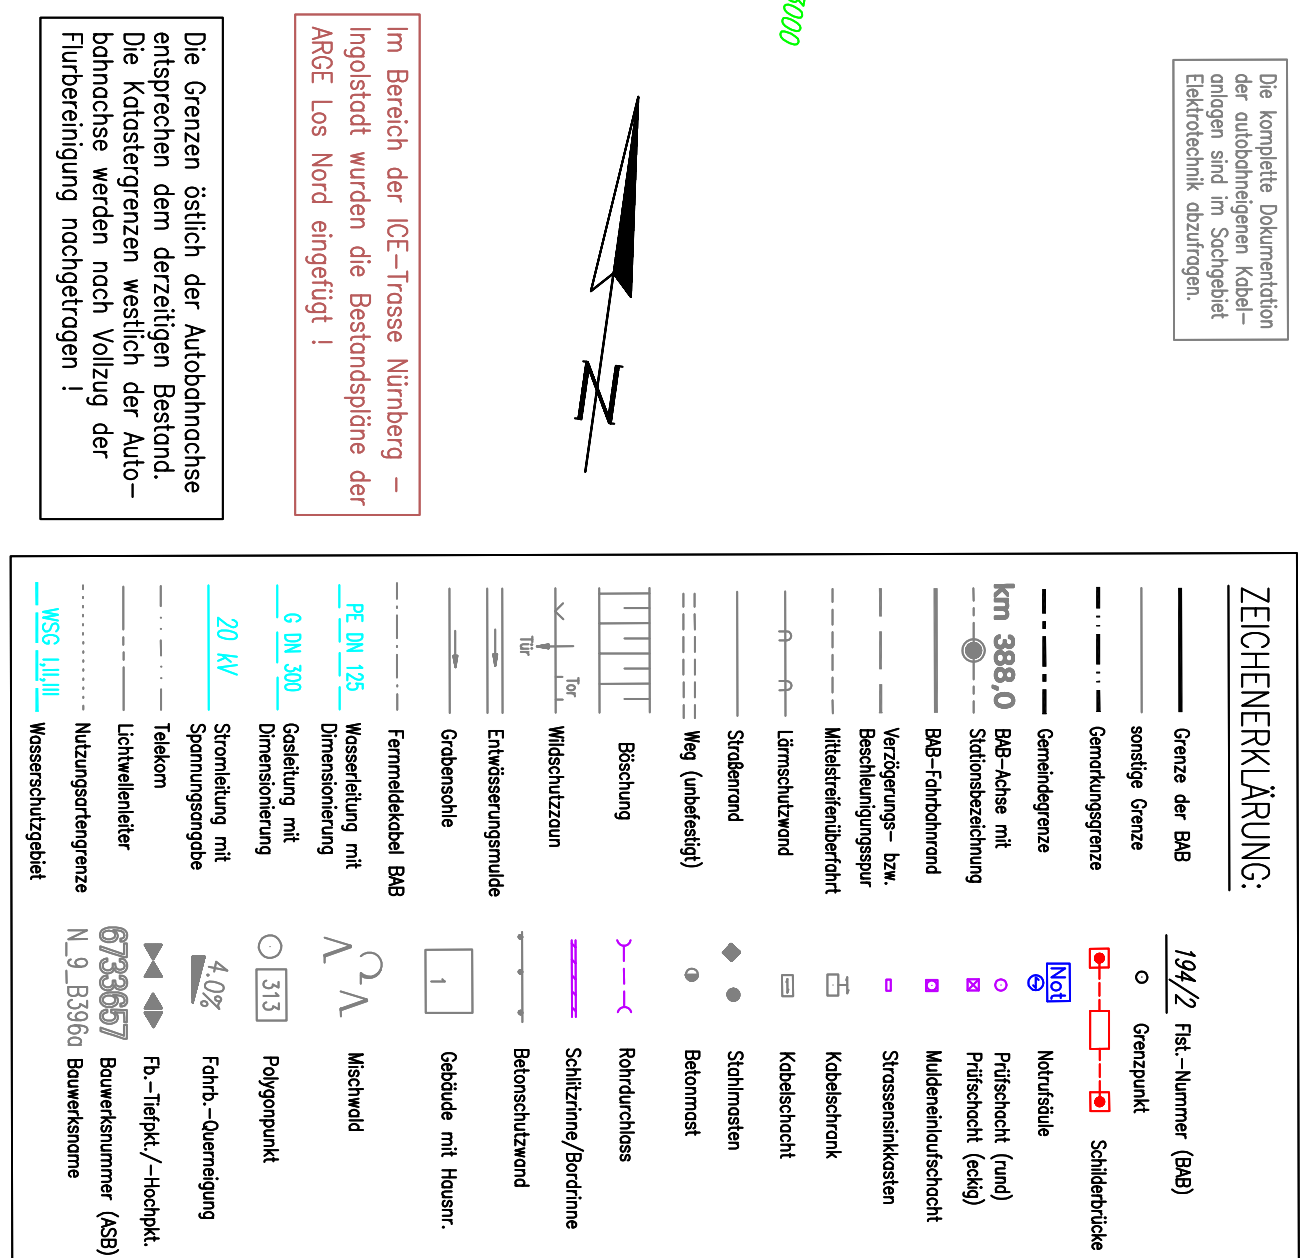
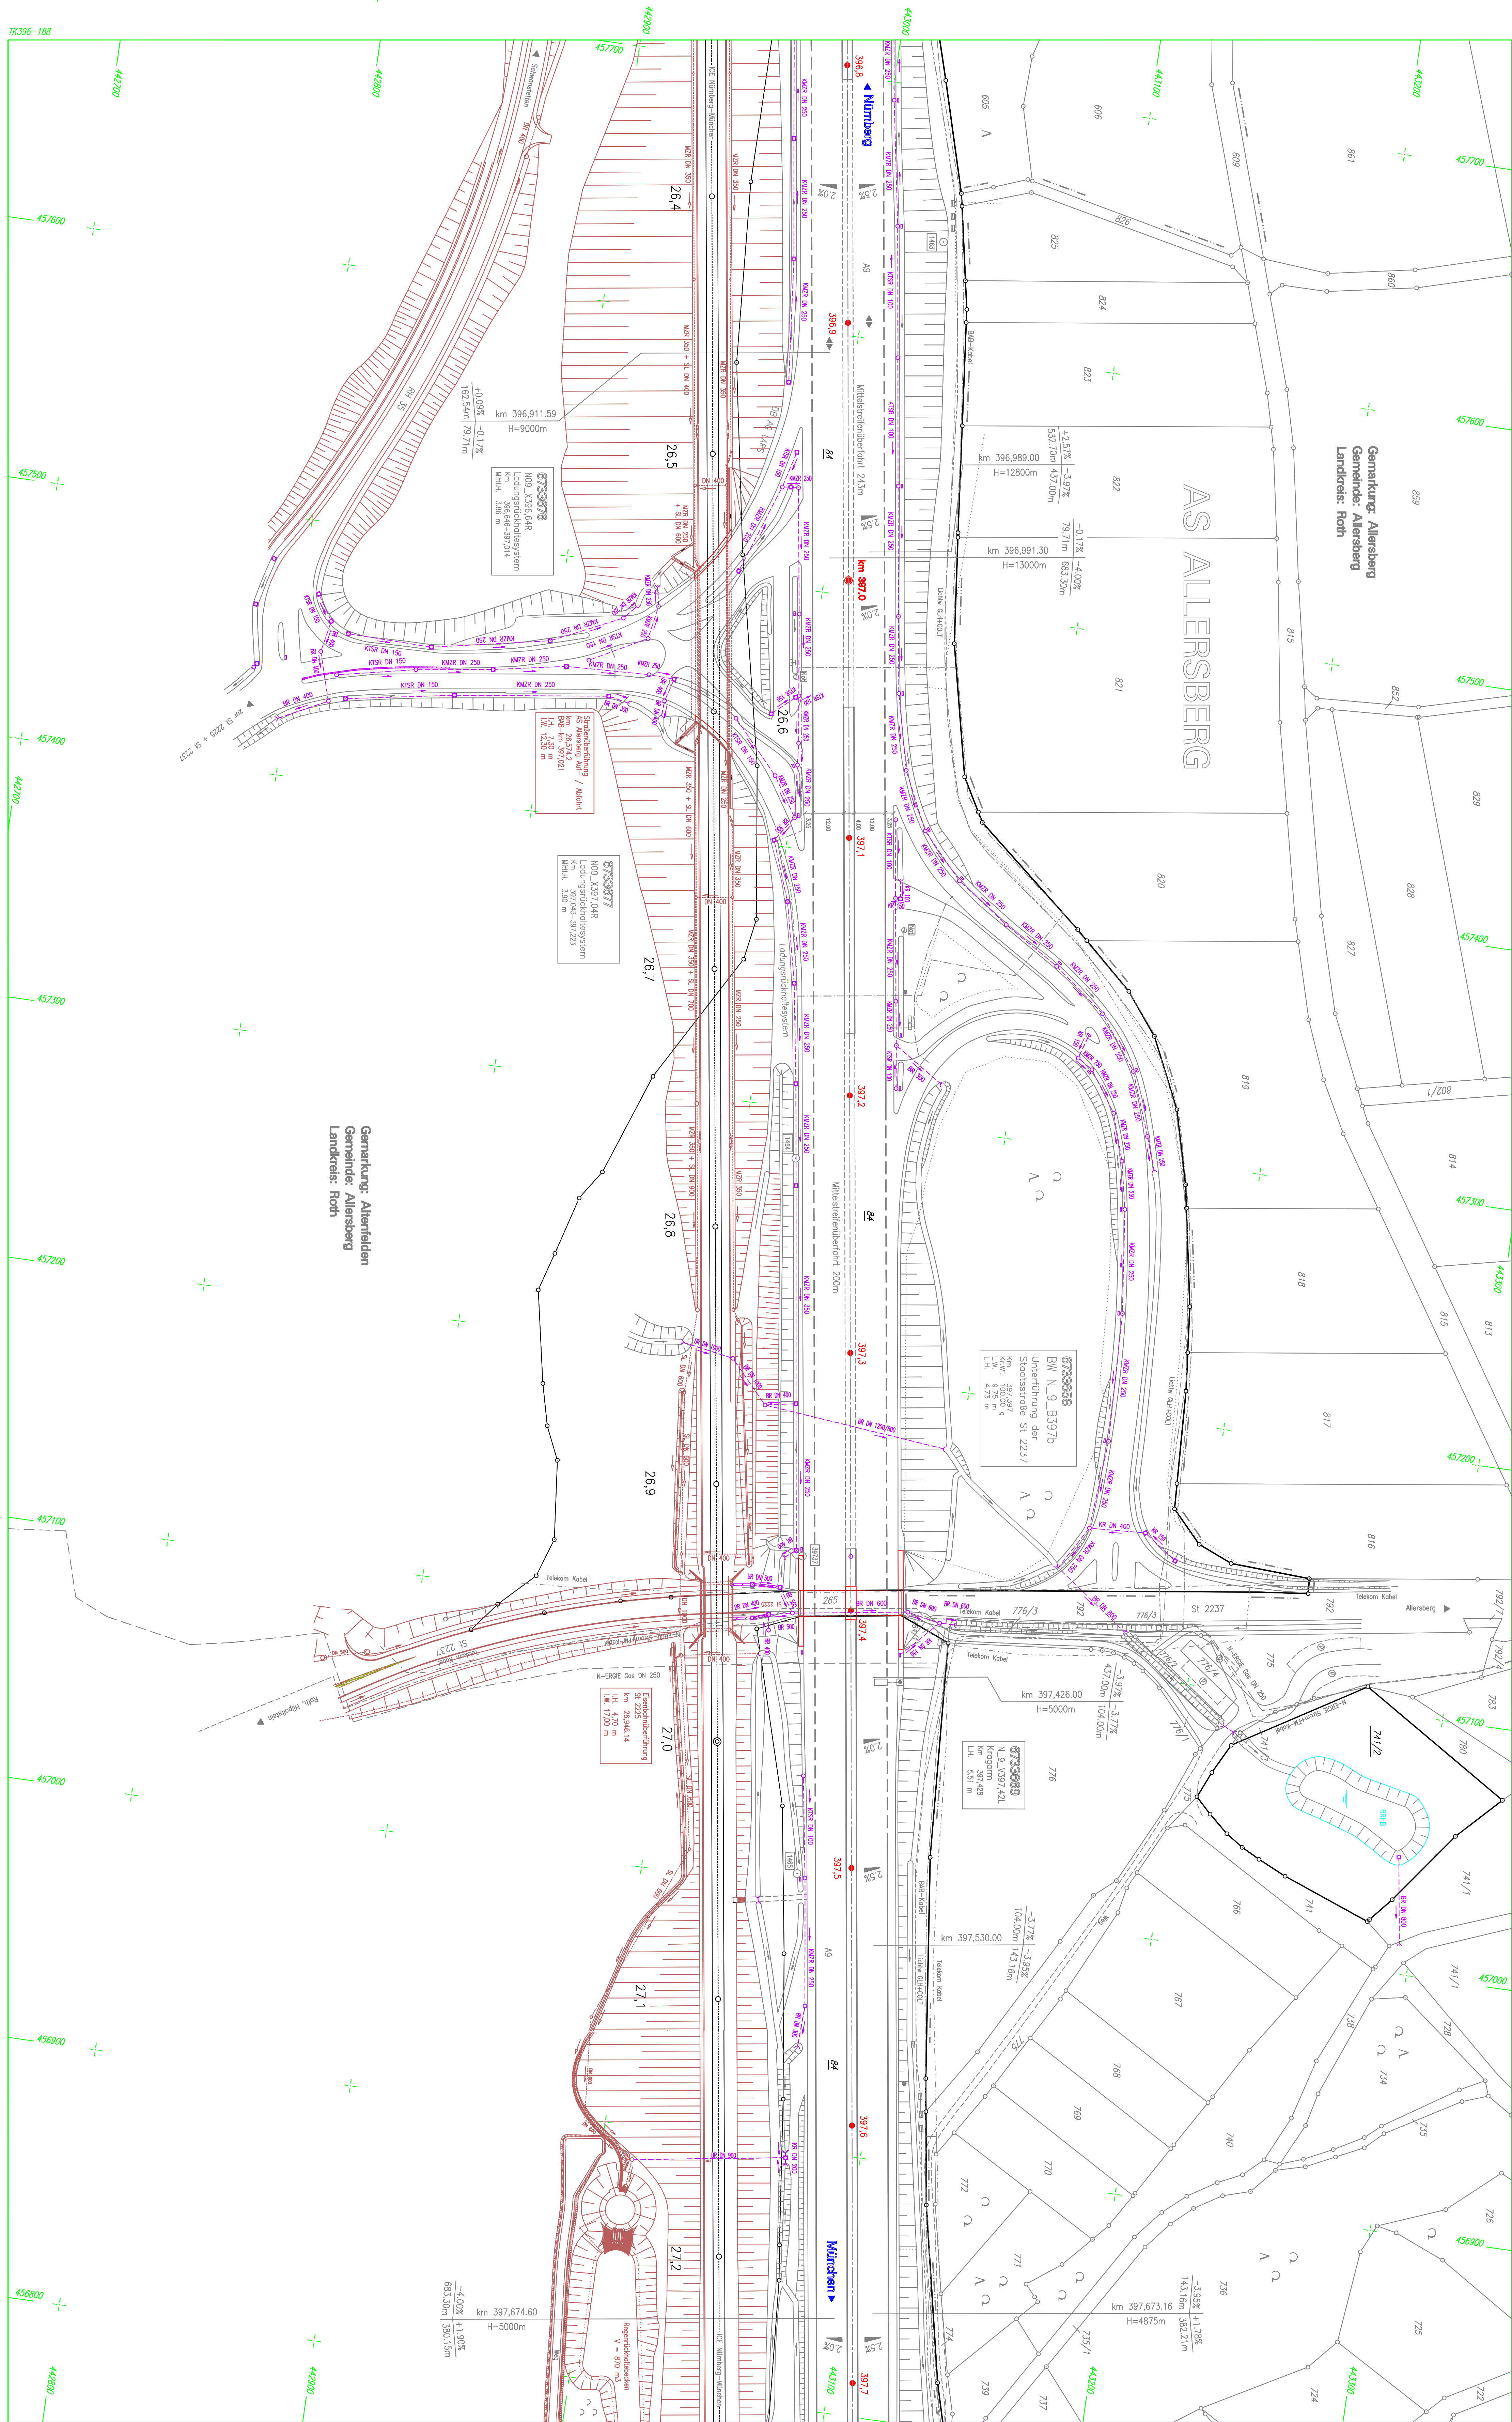


[illegible]