


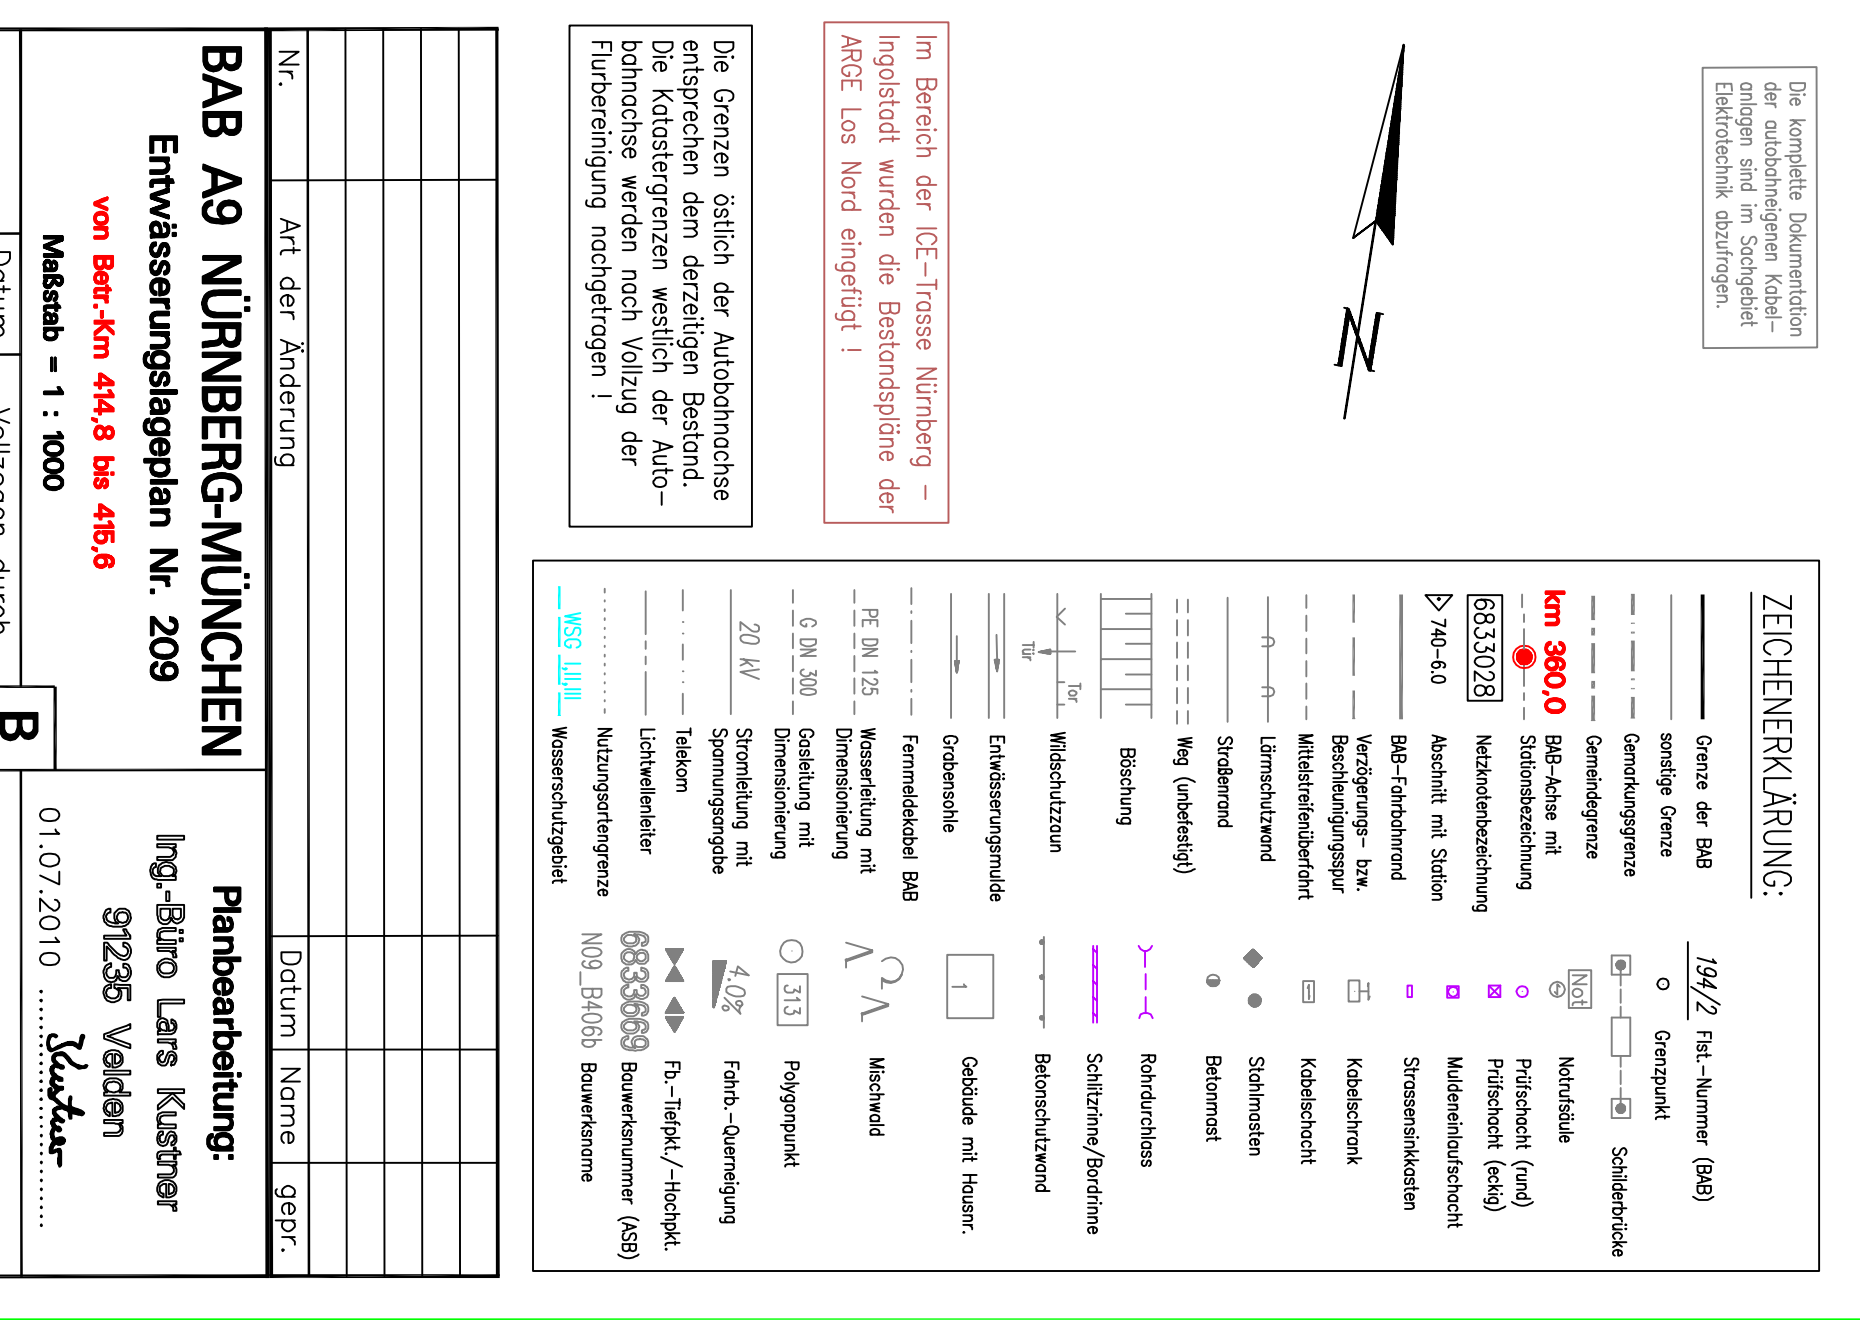

---