


A 553, Km 8,9, FR. Brüll

Anlage 12

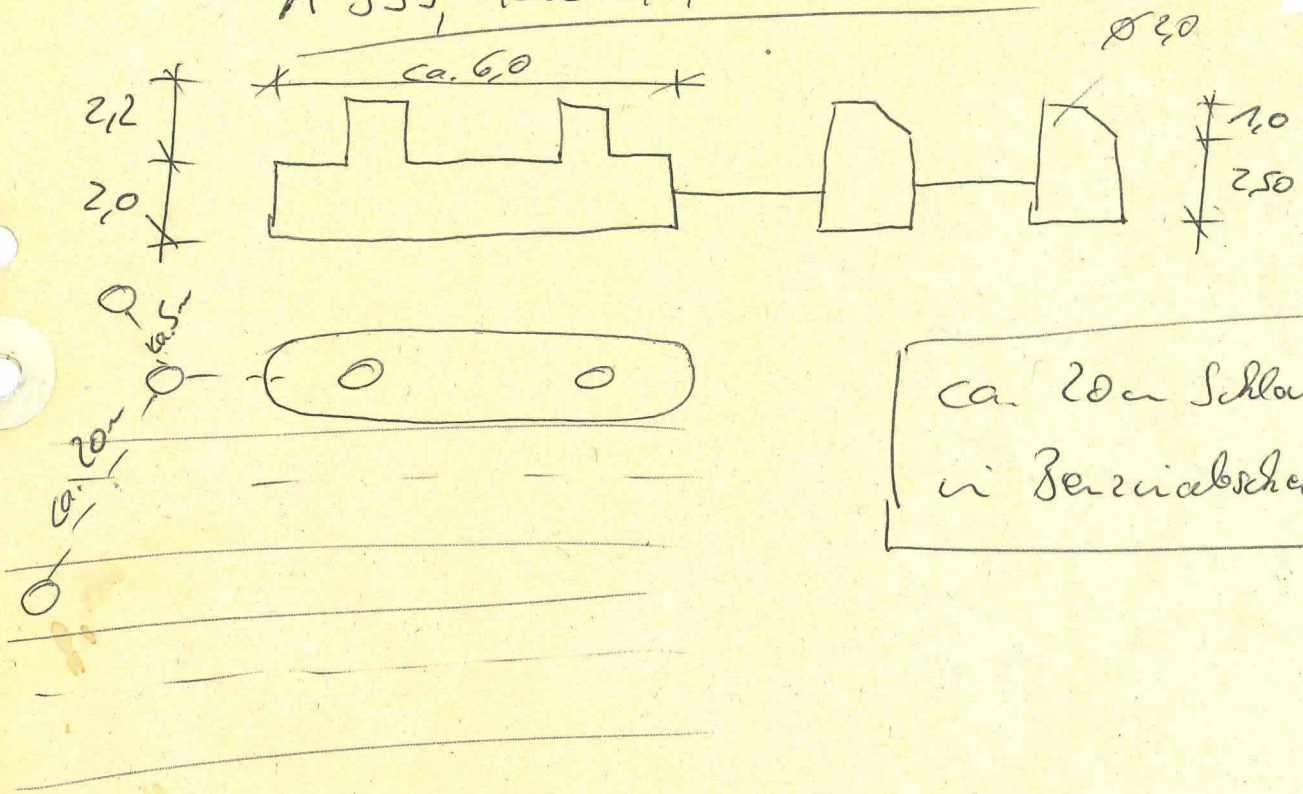

A 553, Km 8,0, FR. Euskirchen

Anlage 12

