


4.50

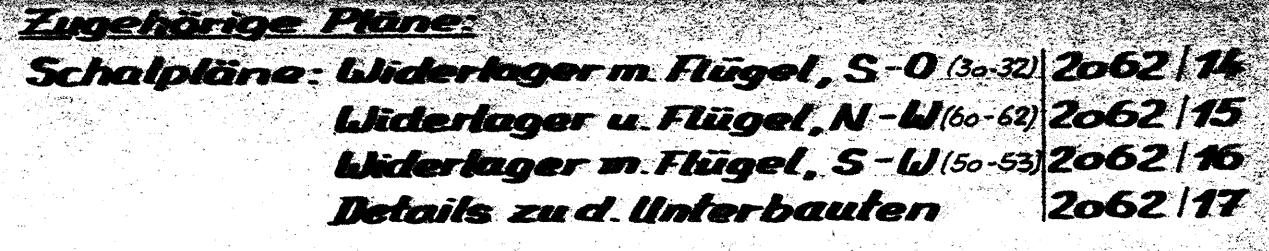

1. Ausfertigung

In statischer Hinsicht geprüft

Prüfnummer: 2 2 4 des Prüfverzeichnisses 1965 15. Juli 1966

100-1-1066 *AD* *al* Erl.....

18. Juli 1960 *E. Merkel*

Prüfingenieur für Baustatik gemäß Verordnung vom
19. Juli 1962 (GVN. S. 470) für die Fachrichtung

Massivbau

DIPL.-ING. EUGEN PIRLET, 5 KÖLN
NEUMARKT (Haus Lempertz), TEL. 210755/56

12

Der Leiter
des Fernstraßen-Nachbauamtes

gesehen:

Prüf.-Nr. 30 Buch: den 22. 62 62 60

Dipl.-Ing.

_____ p

Arbeitsgemeinschaft

Freitag KG - Ph. Holzmann AG

Fernstraßenneubauamt Beuel

Datum	Name	☐ WAYSS & FREYTAG
-------	------	---

WILHELM KRAUSE & CO.
KOMMANDITGESELLSCHAFT

			NIEDERLASSUNG KÖLN
--	--	---	---------------------------

Zeichnungs-Nr. 31/EP12

2062/13

Widerlager m. Flügel

Ost Abschnitte 40-43 Erweit


halplan	Erstellt durch
----------------	----------------